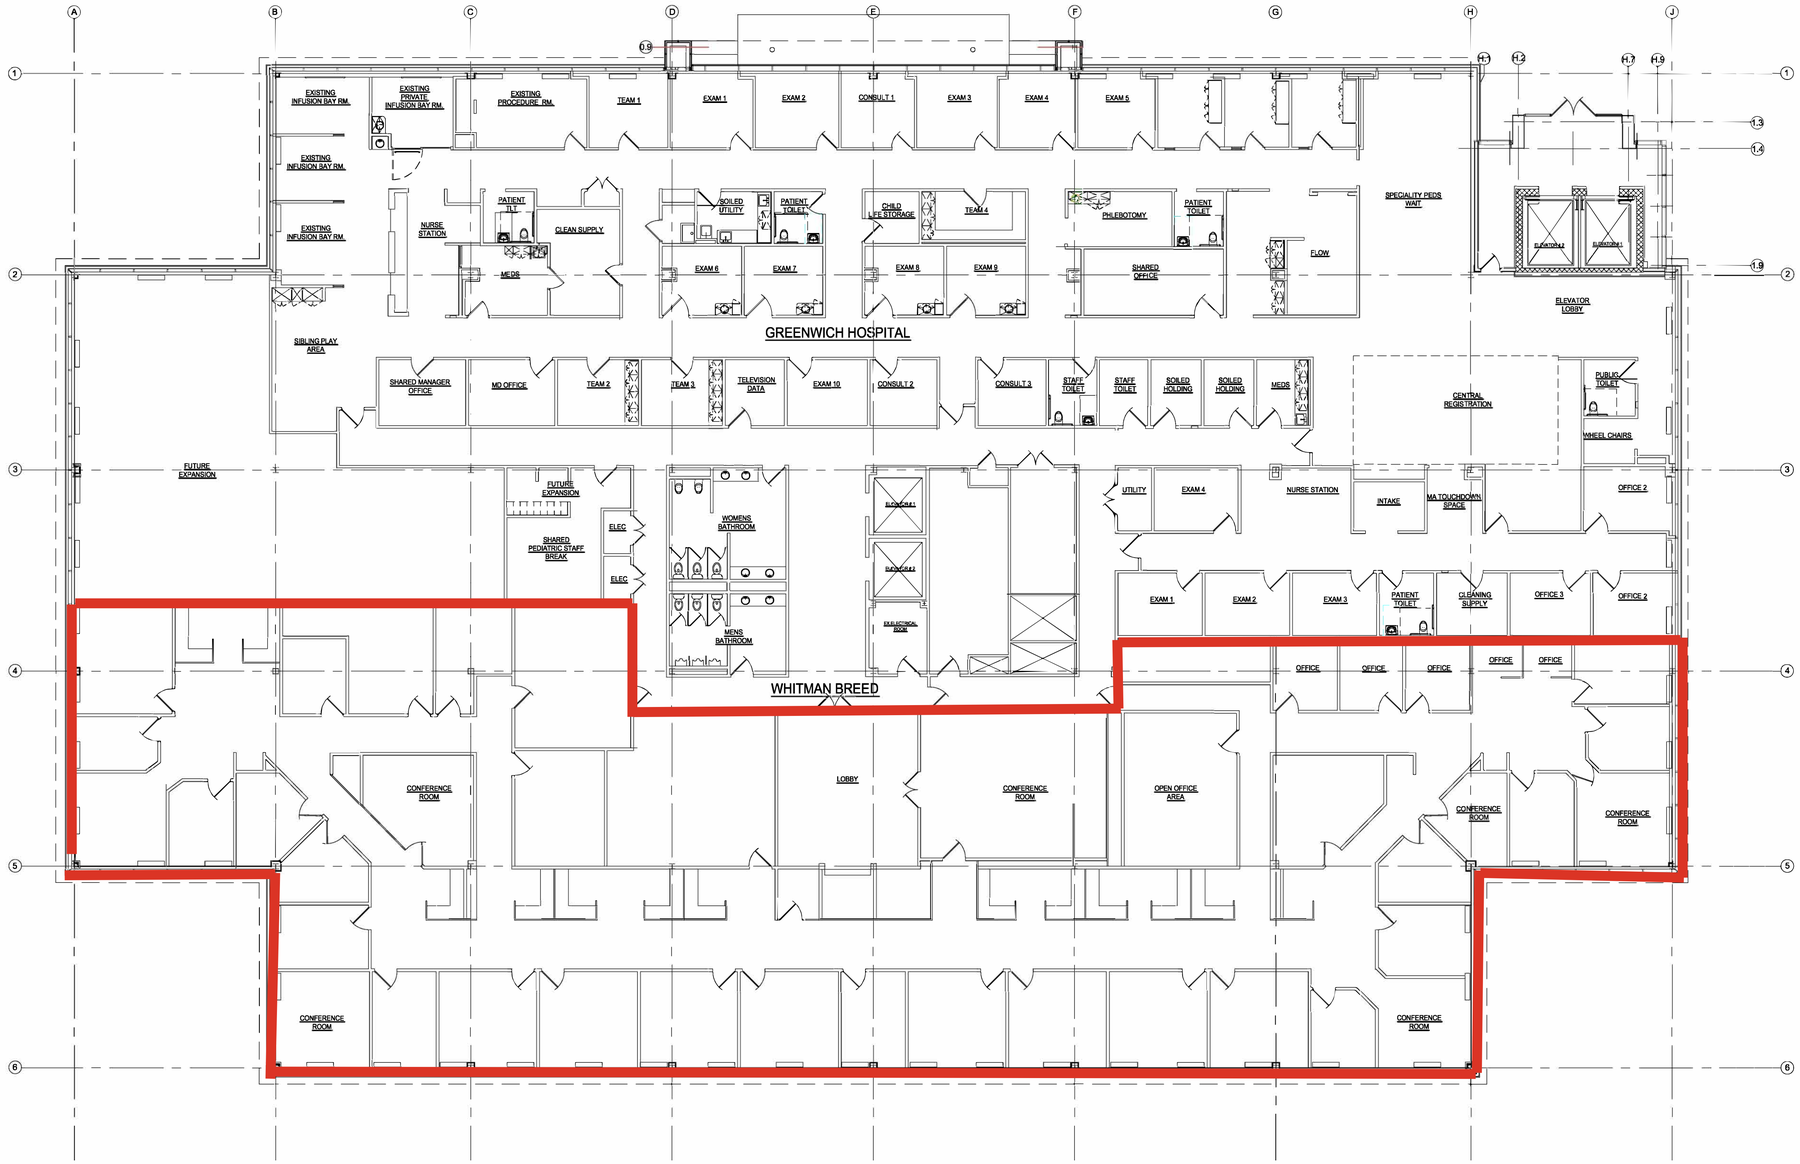

D1 EXISTING FLOOR PLAN : SECOND FLOOR

SCALE: $\frac{3}{32}$" = 1'-0"

DATE	DESCRIPTION
05.03.2019	AS-BUILT COMPILED

PROJECT TITLE:

5 0 0 W P A
G R E E N W I C H - C T

DRAWING TITLE:

EXISTING SECOND FLOOR PLAN-COMPILED

BUILDING LEVEL

S E C O N D F L O O R

DRAWING NUMBER:

A-102-E